



TOWNSHIP No. IX RANGE No. V.

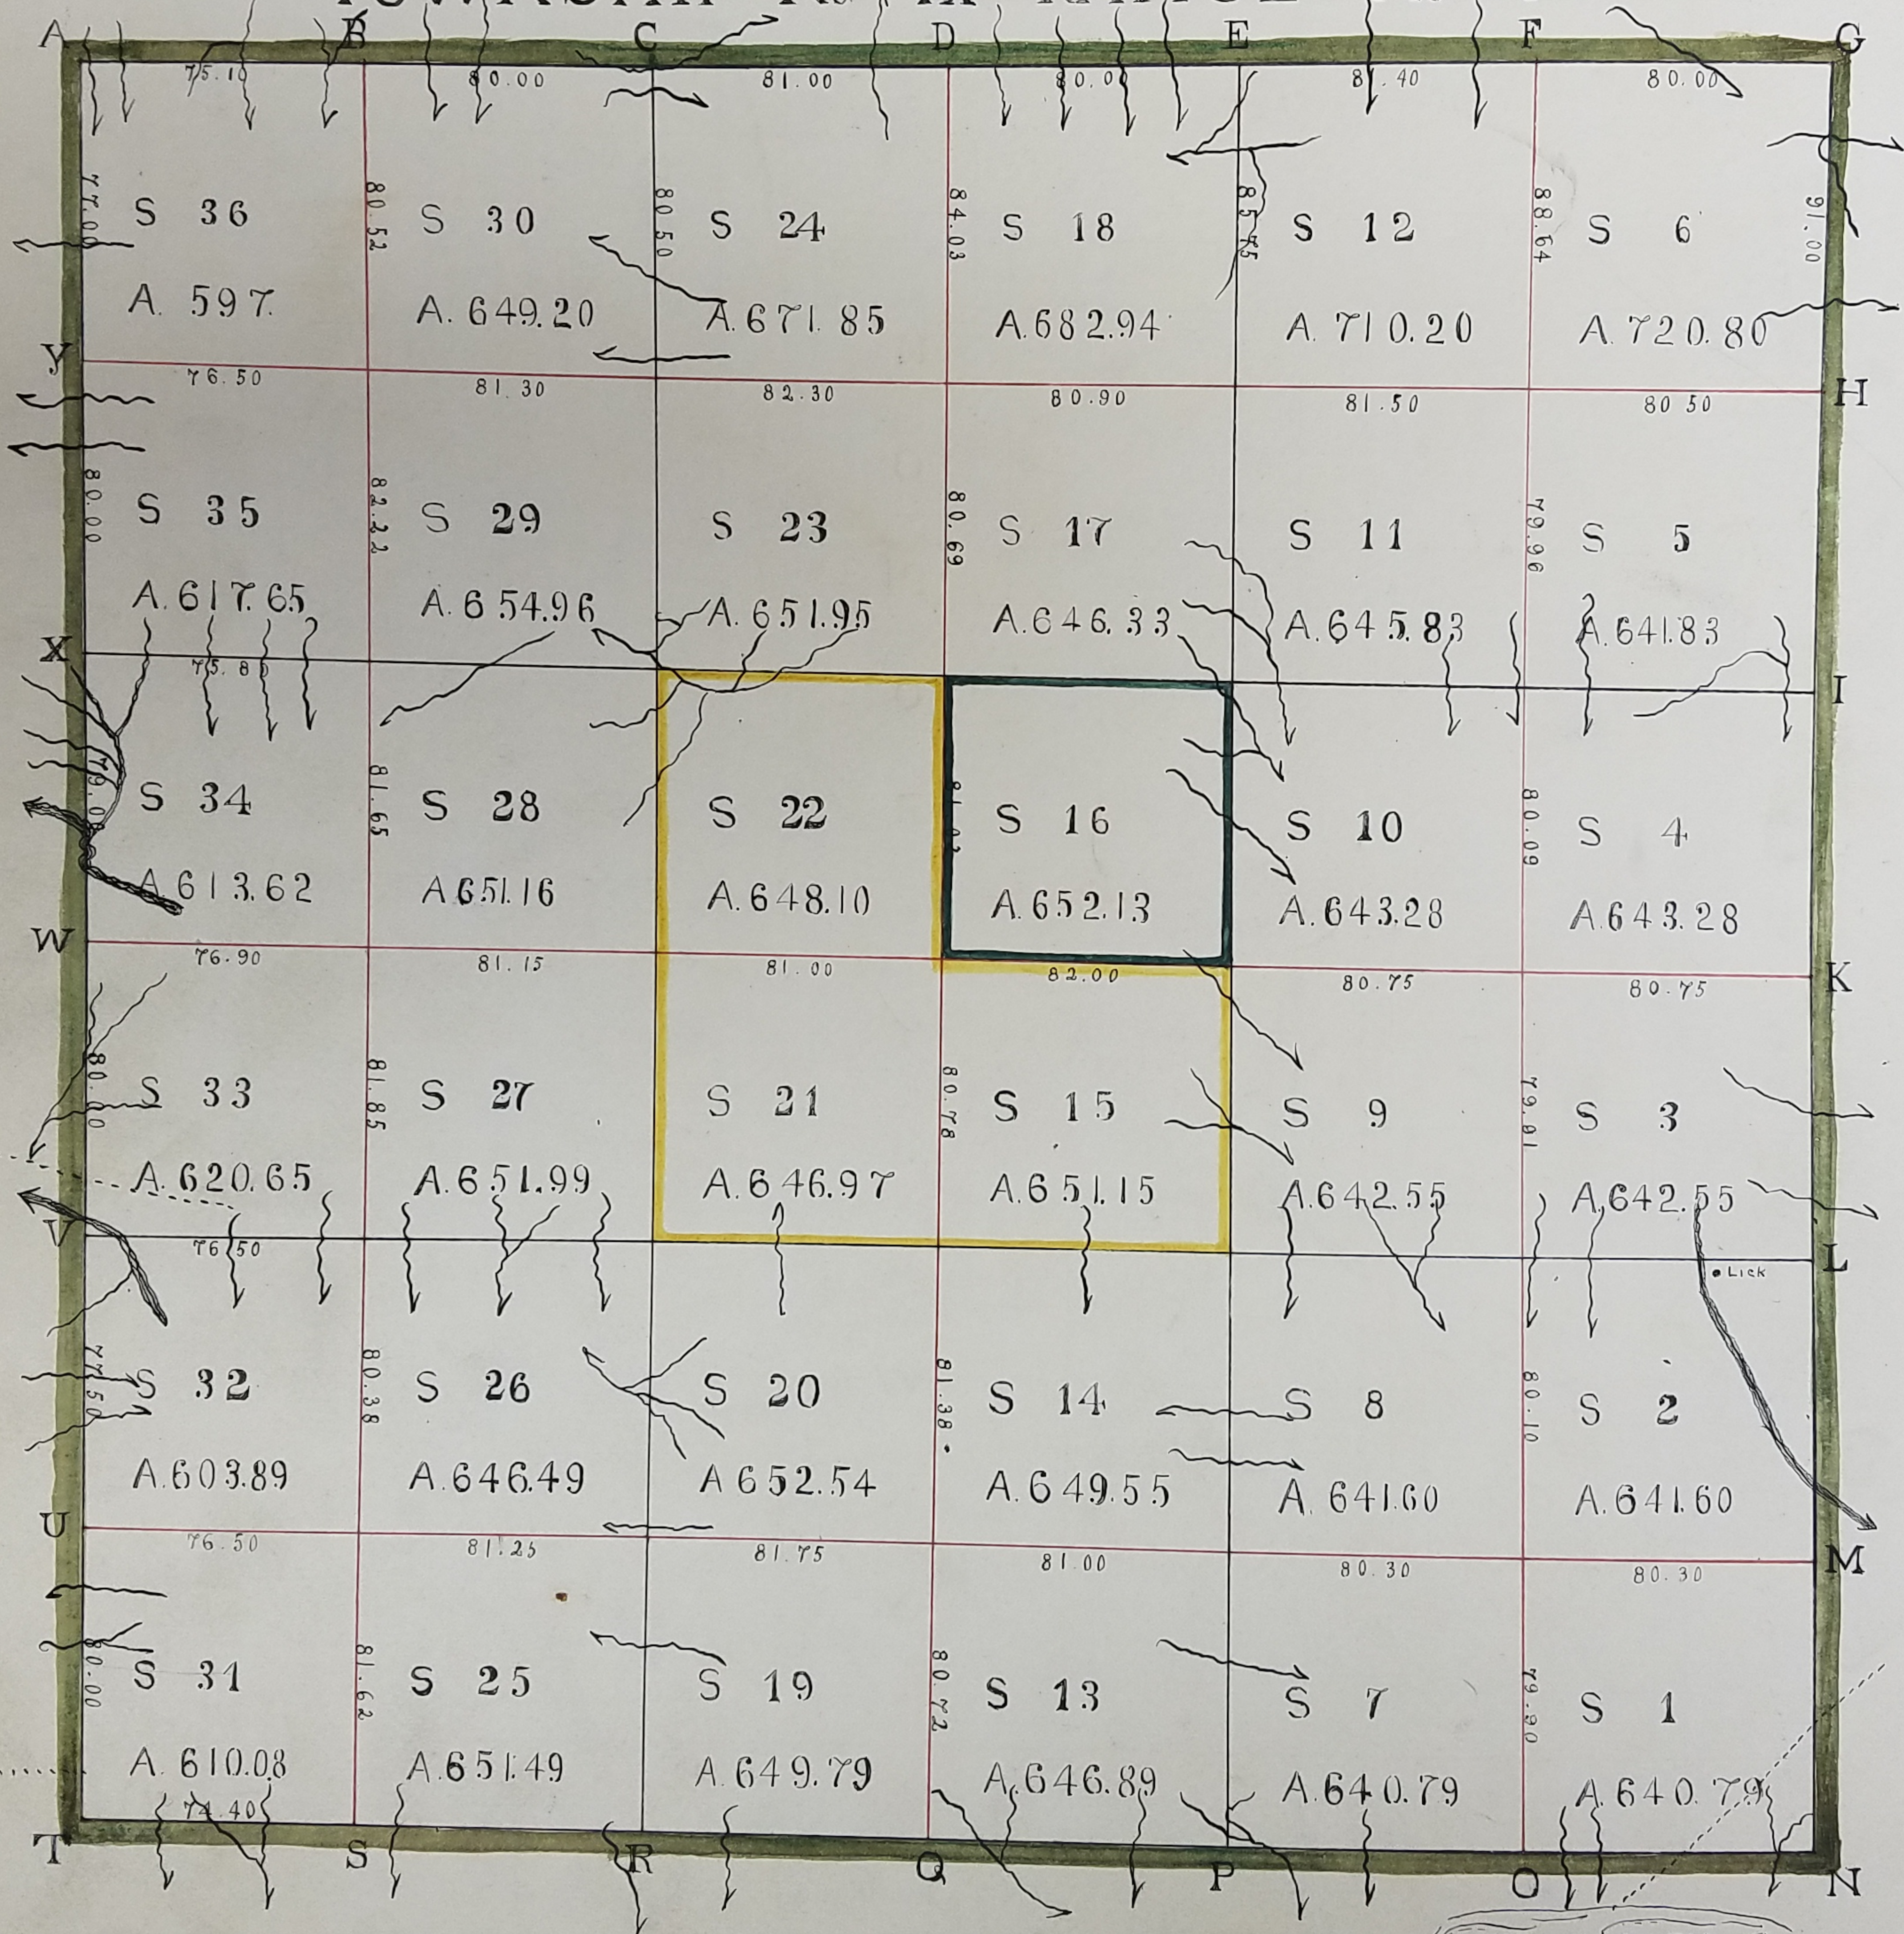

A TRUE COPY
DAVID HOCE, REG.

A TRUE COPY
BY
JOHN A. BOND
1894

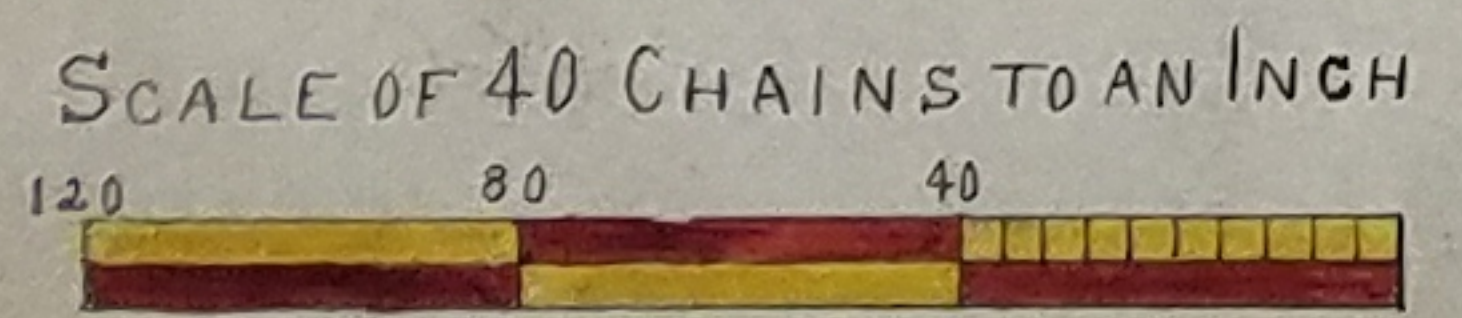

DESCRIPTION OF TOWNSHIP No. IX RANGE No. V

POSTS	BEARING TREES	INCHES DIAM.	COURSE THEY BEAR	LINKS DISTANT	POSTS	BEARING TREES	INCHES DIAM.	COURSE THEY BEAR	LINKS DISTANT
A	W. OAK	13	S 85½ W	21	N	W. OAK	12	N 7 E	40
	GUM	12	S 15½ E	38		DO	08	S 40½ W	24
B	MAPLE	12	S 80 E	05	O	DO	15	N 3 E	42
	BEECH	10	N 5½ E	21½		DO	36	S 6 E	44½
C	W. OAK	12	SOUTH	16½	P	DO	14	N 7 E	05
	DO	12	N 28 W	36		DO	12	S 64 W	20½
D	DO	14	S 74 E	09	Q	DO	12	N 89½ E	22
	B. OAK	16	N 68 W	51		DO	14	N 60½ W	27
E	W. OAK	15	N 18 E	35	R	B. OAK	18	S 75 E	17½
	HICKORY	13	S 12 W	23		DO	18	N 41½ W	65
F	W. OAK	11	S 18 W	01½	S	W. OAK	18	S 56½ W	35
	B. OAK	14	N 69 E	39		DO	14	N 32 W	33
G	W. OAK	12	S 21 W	18½	T	DO	10	N 19 E	21
	DO	10	N 21 E	04½		DO	09	S 65½ W	24
H	DO	15	N 78 E	10½	U	POPLAR	72	S 64 W	36
	B. OAK	16	S W	22		ASH	13	N 40 E	37½
I	W. OAK	16	S 74 E	67½	V	ELM	09	N 63½ W	01½
	HICKORY	12	S 38 E	60		SUGARTREE	12	N 83½ E	45
K	W. OAK	09	N 77 E	47	W	W. OAK	12	N 38 W	32
	DO	10	S 80 W	34		DO	18	S 25 E	26
L	DO	10	N 17½ E	33	X	DO	10	S 42 E	04
	DO	05	S 17½ W	22		DO	11	S 82 W	35
M	DO	09	S 25 E	14½	Y	B. OAK	20	N 65 W	27½
	DO	08	N 9½ E	25½		W. OAK	14	S 20 W	46

RED-LINES
TOWNSHIP No IX RANGE No. V CONTINUED.
QUARTER SECTION POSTS DESCRIBED.

QUARTER POSTS	BEARING TREES	INCHES DIAM.	COURSE THEY BEAR	LINKS DISTANT	QUARTER POSTS	BEARING TREES	INCHES DIAM.	COURSE THEY BEAR	LINKS DISTANT	QUARTER POSTS	BEARING TREES	INCHES DIAM.	COURSE THEY BEAR	LINKS DISTANT
BETWEEN SECTIONS 11 & 12	W. OAK	11	S 67 W	10	BETWEEN SECTIONS 21. 22	B. OAK	10	N 66 1/2 W	26	BETWEEN SECTIONS 7 & 8	W. OAK	11	S 75 E	32 1/2
	DO	18	N 5 1/2 W	11		W. OAK	09	S 21 E	38 1/2		POPLAR	12	S 56 W	33
6. 12	DO	13	N 10 E	15 1/2	16. 22	HICKORY	14	N 20 E	16 1/2	2. 8	ELM	09	S 71 E	47 1/2
	DO	09	S 10 W	15		W. OAK	18	S 43 1/2 W	37		HICKORY	11	N 10 E	29 1/2
5. 11	DOGWOOD	06	N 17 E	03	15. 21	B. OAK	26	S 12 W	16	1. 7	W. OAK	40	N 73 W	52
	HICKORY	11	S 16 W	56		W. OAK	40	N 29 E	27		POPLAR	15	S 73 1/2 E	22
5. 6	B. ASH	12	N 54 W	18 1/2	15. 16	DO	12	N 17 W	14 1/2	1. 2	CHESTNUT	48	S 49 E	18
	W. WALNUT	12	S 30 E	05		DO	12	S 3 1/2 E	26		W. OAK	11	S 18 E	16 1/2
23. 24	ELM	08	S 42 1/2 E	26	33. 34	DO	13	N 56 W	11 1/2	19. 20	B. OAK	18	N 4 W	43 1/2
	HICKORY	11	N 42 1/2 W	31		DO	12	N 77 E	25 1/2		W. OAK	18	S 37 E	38
18. 24	W. OAK	24	S 5 W	20	28. 34	B. OAK	13	N 79 E	52	14. 20	DO	14	S 31 1/2 E	09 1/2
	DO	14	N 56 E	11 1/2		HICKORY	11	S 35 W	14 1/2		MAPLE	09	S 55 W	15
17. 23	DO	12	N 46 W	23	27. 33	DO	11	S 8 W	30	13. 19	W. OAK	12	N 11 W	22
	DO		S 46 E	38		W. OAK	24	EAST	13		CHESTNUT	16	S 30 1/2 W	25
17. 18	B. OAK	13	S 24 W	20	27. 28	DO	18	N 26 W	14	13. 14	W. OAK	22	N 78 W	50
	W. OAK	12	N 62 E	14 1/2		HICKORY	11	S 51 E	20		DO	18	S 30 E	26 1/2
9. 10	HICKORY	15	N 52 E	19 1/2	35. 36	B. OAK	14	N 12 W	36	31. 32	DO	40	S 61 W	08
	W. OAK	11	S 22 W	30		W. OAK	15	S 5 W	50		B. OAK	24	N 63 1/2 E	18
4. 10	DO	12	S 15 1/2 W	09 1/2	30. 36	ELM	09	N 17 W	03	26. 32	HICKORY	11	N 28 1/2 E	40
	DO	10	N 82 E	28 1/2		B. OAK	15	S 17 1/2 W	40		B. OAK	16	N 89 W	31
3. 9	DO	20	S 81 E	18	29. 35	W. OAK	12	S 88 1/2 W	19 1/2	25. 31	W. OAK	24	N 12 E	34
	HICKORY	12	N 45 1/2 W	31		DO	15	S 50 1/2 E	19 1/2		HICKORY	06	S 13 1/2 E	16
3. 4	W. OAK	11	S 54 E	01 1/2	29. 30	DO	11	S 5 W	16	25. 26	SUGAR	14	N 15 E	20
	B. OAK	22	S 56 W	07		DO	14	N 19 1/2 E	29		W. OAK	22	S 23 1/2 W	59

TOWNSHIP No. IX RANGE No. V CONTINUED

INTERIOR SECTION CORNERS BLACK-LINES

SECTION CORNERS	BEARING TREES	INCHES DIAM.	COURSE THEY BEAR	LINKS DISTANT	SECTION CORNERS	BEARING TREES	INCHES DIAM.	COURSE THEY BEAR	LINKS DISTANT		
7 13	8 14	W OAK	12	S 11 E	25	20 26	21 27	W OAK	12	N 76 W	19 1/2
8 14	9 15	B OAK	16	N 45 W	23	14 20	15 21	POPLAR	18	S 51 E	70
		W OAK	13	N 22 E	42 1/2			W OAK	13	CORNER	TREE
		DO	10	S 51 W	36			DO	13	S 40 E	59
2 8	3 9	SUGARTREE	13	N 60 W	37			DO	28	N 8 1/2 E	50
		DO	11	S 89 E	60	26 32	27 33	POPLAR	10	S 12 E	21
9 15	10 16	W OAK	14	S 33 1/2 E	11			HICKORY	10	N 13 W	37 1/2
		DO	14	N 28 1/2 W	22	21 27	22 28	W OAK	36	S 37 W	38
10 16	11 17	DO	13	N 65 W	39			DO	12	N 41 E	48
		DO	12	N 80 E	28	22 28	23 29	ELM	16	N 30 W	12
4 10	5 11	DO	16	S 38 1/2 E	17			DO	34	S 27 W	30
		GUM	16	N 50 W	36	16 22	17 23	B OAK	16	N 10 1/2 W	59
11 17	12 18	W OAK	20	N 38 E	55			W OAK	38	S 22 1/2 E	49 1/2
		DO	17	S 14 E	51	23 29	24 30	DO	13	N 5 1/2 E	24 1/2
19 25	20 26	DO	15	N 57 1/2 W	29			DO	11	S 62 1/2 E	33 1/2
		HICKORY	15	S 64 E	51	28 34	29 35	HICKORY	22	N 63 W	23
								W OAK	13	N 89 E	52

INTERIOR SECTION CORNERS RED-LINES

SECTION CORNERS	BEARING TREES	INCHES DIAM.	COURSE THEY BEAR	LINKS DISTANT	SECTION CORNERS	BEARING TREES	INCHES DIAM.	COURSE THEY BEAR	LINKS DISTANT		
5 11	6 12	W OAK	12	S 56 1/2 W	16	28 35	30 36	GUM	11	N 19 E	19
		DO	08	N 52 E	27			BEECH	12	S - W	34
17 23	18 24	BEECH	12	S 76 W	37	1 7	2 8	W OAK	12	N 21 W	21 1/2
		W OAK	18	N 81 1/2 E	37 1/2			DO	11		32
3 9	4 10	DO	20	N 45 W	01	13 19	14 20	DO	12	N 48 1/2 E	09 1/2
		HICKORY	11	S 82 E	13			DO	20	S 48 W	42 1/2
15 21	16 22	W OAK	10	N 8 1/2 W	14	25 31	26 32	POPLAR	22	S 47 E	15
		DO	24	S 21 E	31			W OAK	28	N 30 W	30
27 33	28 34	DO	20	N 32 E	07						
		DO	14	S 42 1/2 W	26						

A TRUE COPY
BY
DAVID HOGE REG.

A TRUE COPY
BY
JOHN A. BOND
© 1894