



TOWNSHIP No VII RANGE No III CONTINUED

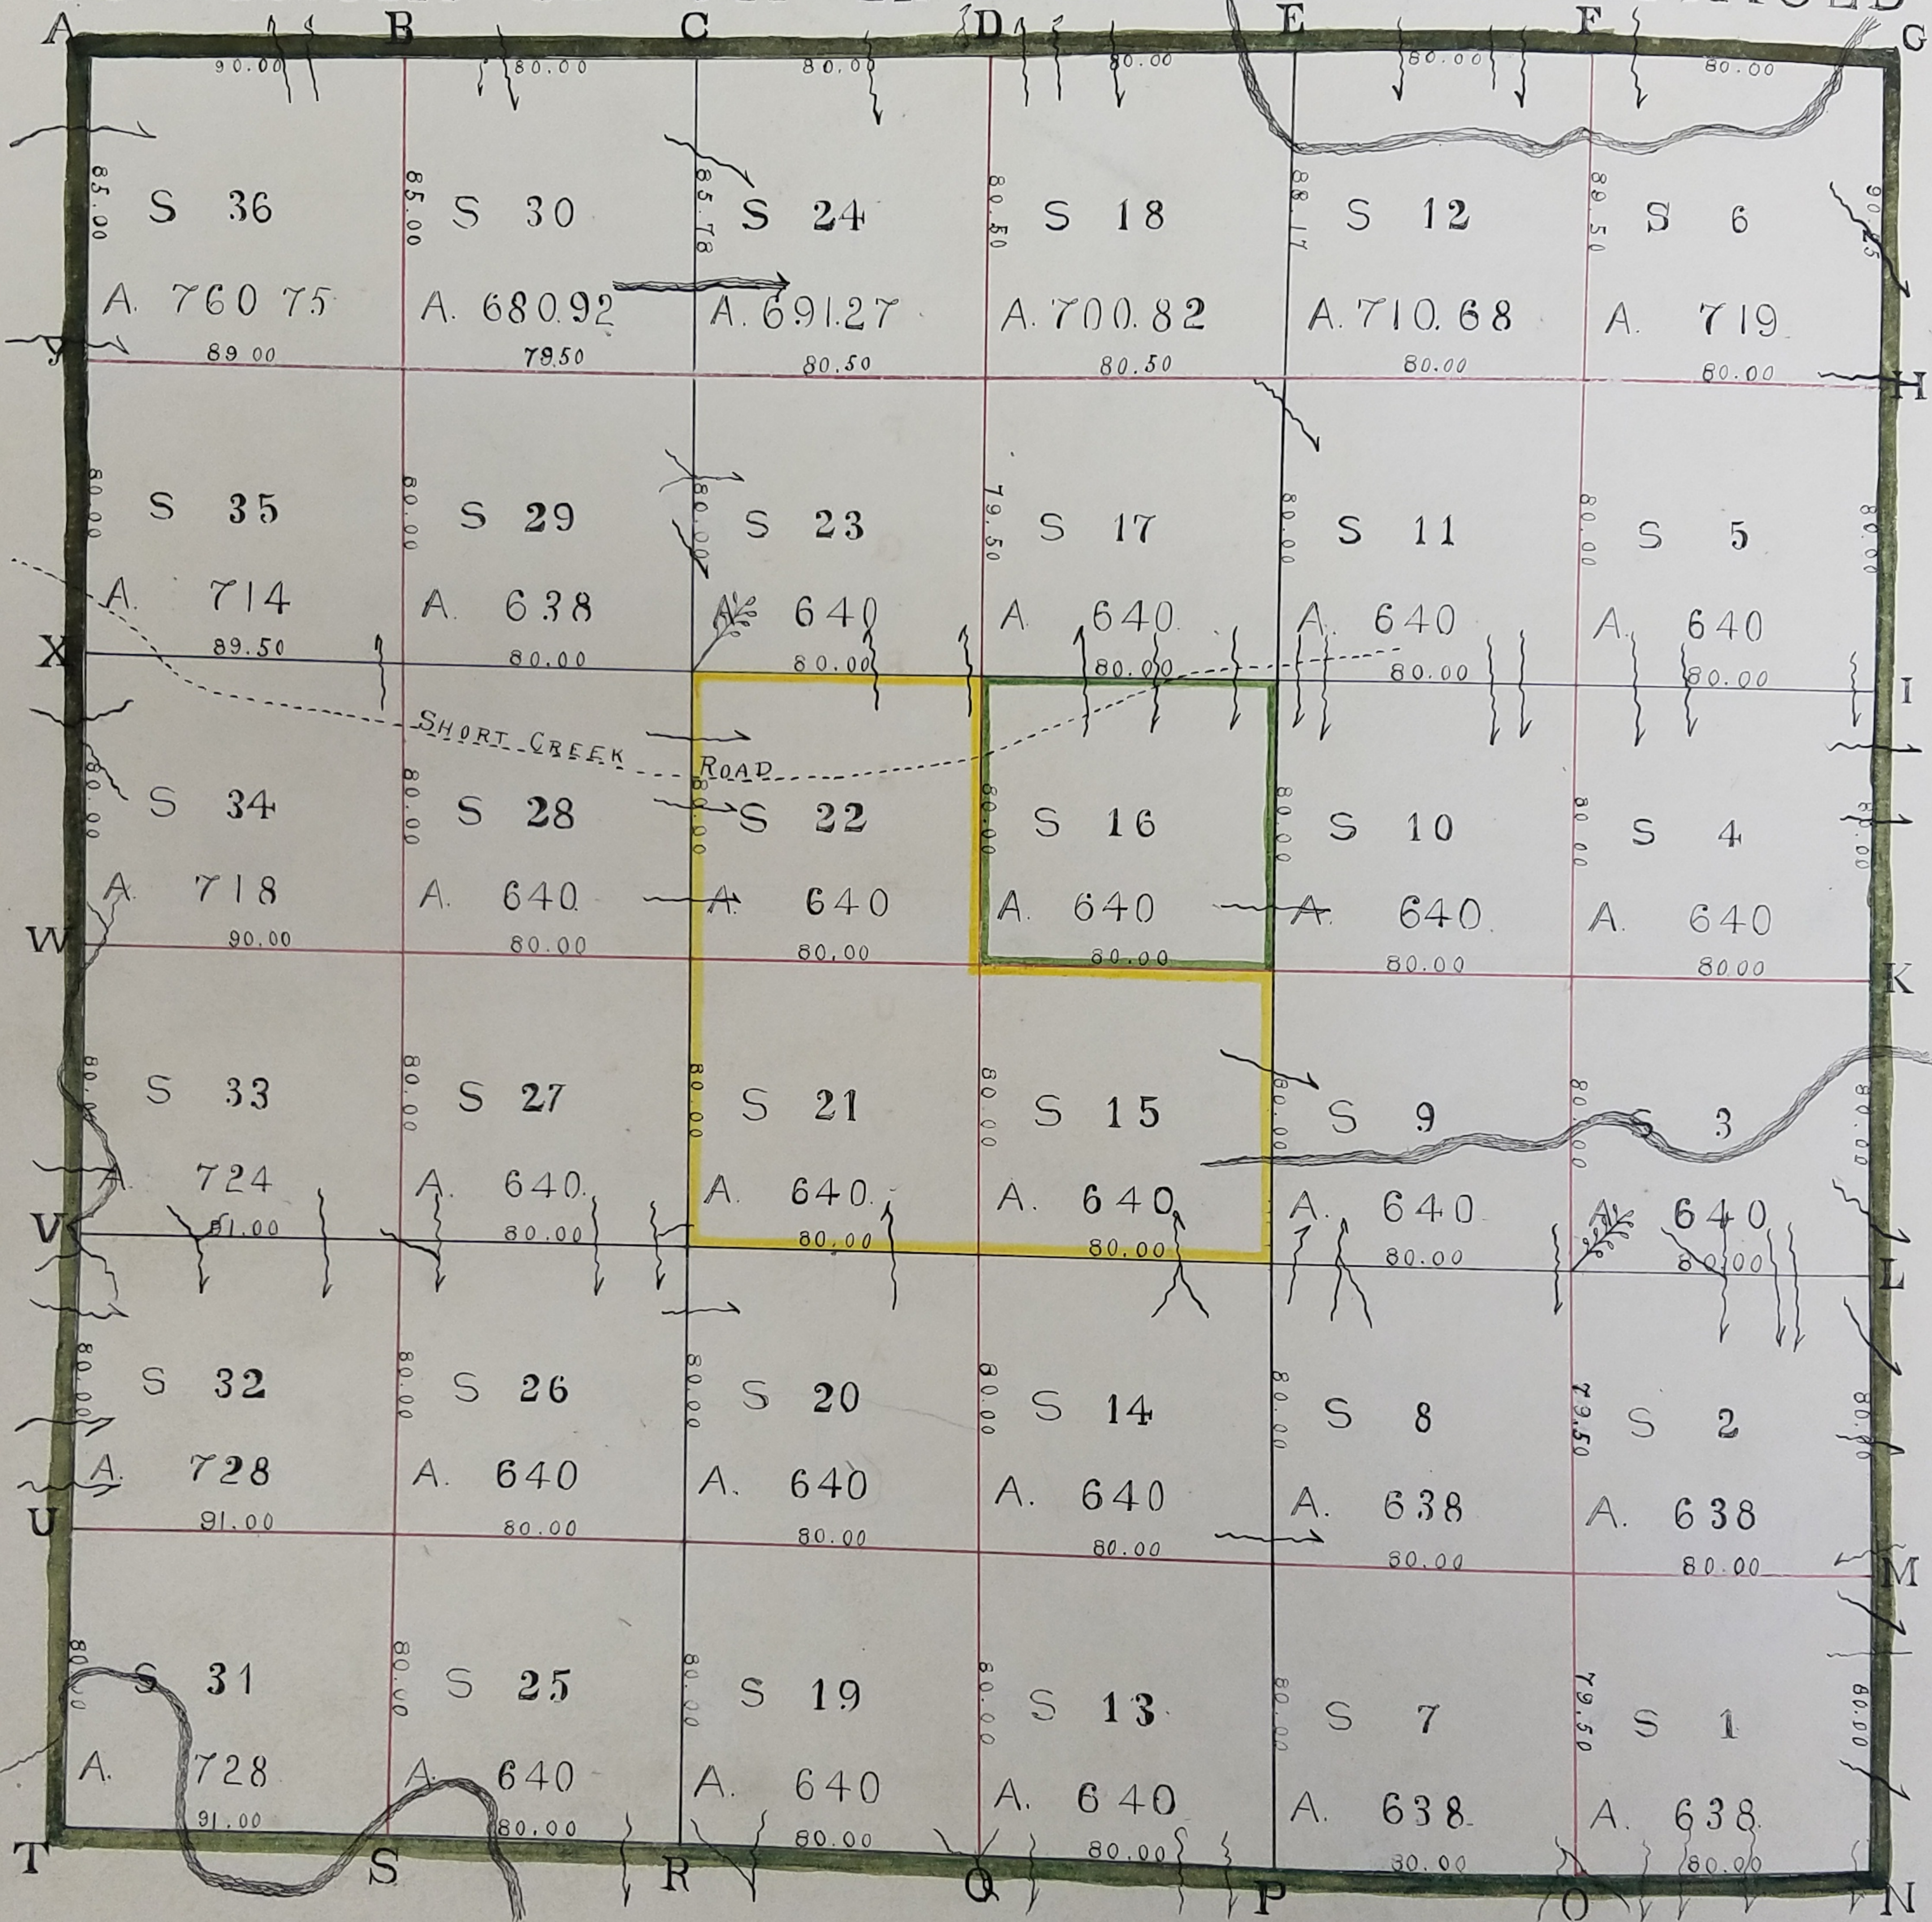

A TRUE COPY
DAVID HOCE REG.

A TRUE COPY
BY
JOHN A. BOND
1894

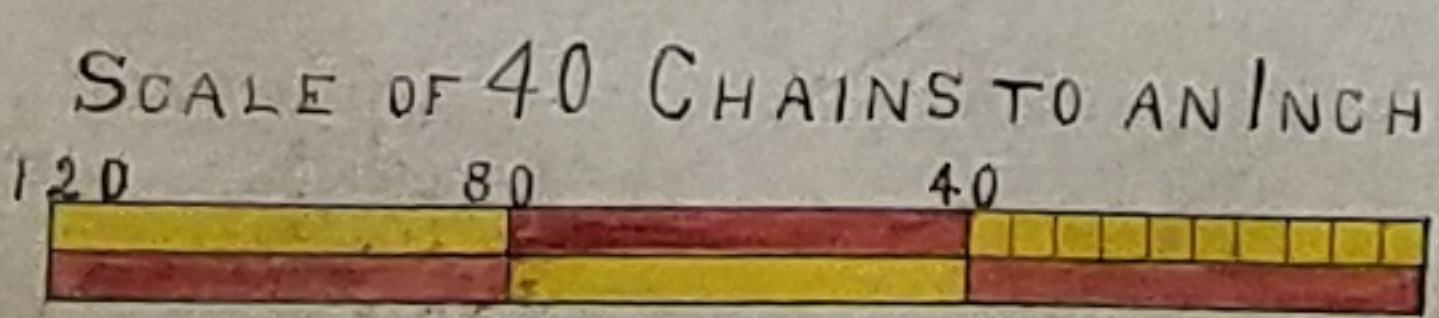

DESCRIPTION TOWNSHIP No. VII RANGE No. III.

POSTS	BEARING	INCHES DIAM.	COURSE	LINKS DISTANT	POSTS	BEARING	INCHES DIAM.	COURSE	LINKS DISTANT
	TREES		THEY BEAR			TREES		THEY BEAR	
A	W. OAK	10	N 31½ W	10	O	BEECH	14	N 57 E	27
	DO.	12	S 44 E	34		SUGARTREE	06	S 60 W	11
B	DO.	08	N 30 W	42	P	HICKORY	18	EAST	15½
	DO.	12	S 68 E	48		SUGARTREE	07	N 80½ W	12
C	B. OAK	10	N 7½ W		Q	HICKORY	10	S 45 W	28½
	W. OAK	14	S 1½ E			DO.	07	N 28 E	24
D	HICKORY	10	N 55½ E	27	R	MAPLE	08	N 2 E	16
	MOHOGONY	04	S 22 W	25		DOGWOOD	05	S 15 E	12½
E	SUGARTREE	08	N 49 E	19	S	W. OAK	46	N 42 W	35½
	HICKORY	08	S 62 W	26		HONEY LOCUST	16	S 48½ E	40
F	W. OAK	12	N 69 W	22	T	B. OAK	12	S 50½ E	31
	GUM	09	N 72 E	23		W. OAK	08	N 23½ W	06
G	ELM	08	S 84 W	21½	U	HICKORY	14	N 84½ W	05
	SUGARTREE	10	N 61½ E	37		SUGARTREE	07	S 33 E	10½
H	BEECH	20	SOUTH	20	V	ELM	08	S 10 E	17
	W. WALNUT	20	S 76 E	21		DO.	06	N 46 W	16
I	BEECH	07	S 47½ E	7	W	W. OAK	14	N 12 E	27
	DO.	16	N 40 W	19½		SUGARTREE	10	S 31½ W	30
K	W. OAK	16	N 45 E	36	X	W. OAK	08	N 76 E	35
	BEECH	09	S 35 W	17		ELM	05	N 58½ W	46
L	DO.	16	N 75 W	16	Y	W. OAK	07	S 55 E	29
	DO.	18	S 83 E	26½		B. OAK	16	N 63 W	10
M	DO.	15	S 3 E	25					
	DO.	15	N 3 W	32½					
N	SUGARTREE	08	N 60 E	17					
	W. OAK	32	N W	21½					

RED-LINES
TOWNSHIP No. VII RANGE No. III CONTINUED
QUARTER SECTION POSTS DESCRIBED

QUARTER POSTS	BEARING TREES	INCHES DIAM.	COURSE THEY BEAR	LINKS DISTANT	QUARTER POSTS	BEARING TREES	INCHES DIAM.	COURSE THEY BEAR	LINKS DISTANT	QUARTER POSTS	BEARING TREES	INCHES DIAM.	COURSE THEY BEAR	LINKS DISTANT
BETWEEN SECTIONS 33 & 34	W. OAK	10	N 17 W	29	BETWEEN SECTIONS 13 & 19	ELM	04	S 64 W	10	BETWEEN SECTIONS 11 & 12	SUGAR	08	S 52 W	19
	DO.	09	S 2 E	06		ASH	05	N 67 E	28		W. OAK	20	N 4 E	26
27.28	DO	16	S 14 E	38	13.14	DO	12	S 86 W	36	6.12	SUGAR	12	N 13 E	10
	DO	17	N 37 W	28		SUGAR	06	N 86 E	19		DO	11	S 21 W	95
28.34	HICKORY	08	S 72 E	05	19.20	DO	14	S 52 E	11	5.6	BEECH	16	S 77 E	13
	W. OAK	12	N 58 W	35		W. OAK	04	N 27 W	27		DO	10	N 68 W	33
27.33	BEECH	05	S 79 E	28	14.20	DO	18	S 16 W	26	5.11	SUGAR	08	S 28 W	07
	W. OAK	12	N 45 W	27		DO	18	N 5 E	17		DO	09	N 44 E	23
25.31	HICKORY	06	S 73 E	10	30.36	B. OAK	16	N 19 E	25	4.10	SUGAR	14	N 88 E	26
	W. OAK	12	N 88 W	46		W. OAK	14	S 36 W	16		DO	08	N 88 W	35
31.32	HICKORY	14	S 38 W	28	35.36	DO	24	N 58 W	11	9.10	W. OAK	14	S 2 E	15
	WAL	09	N 48 W	26		SUGAR	10	S 76 E	30		ELM	06	N 7 W	23
25.26	SUGAR	07	N 56 W	03	29.35	W. OAK	12	S 84 E	24	3.4	WAL	07	S 60 W	15
	W. OAK	14	S 46 E	27		HICKORY	14	N 26 W	31		DO	08	N 32 E	23
26.32	HICKORY	12	S 59 E	11	29.30	ELM	05	N 76 W	05	3.9	CHEERY	16	S 49 E	04
	W. OAK	09	N 30 W	30		SUGAR	24	S 15 E	29		BEECH	14	WEST	35
15.16	HICKORY	12	N 12 W	27	23.24	W. OAK	18	WEST	17	2.8	HICKORY	14	SOUTH	06
	NO OTHER	TIMBER	NEAR			DO	12	S 21 E	49		BEECH	12	N 34 W	26
16.22	SUGAR	10	N 7 E	08	18.24	RED OAK	30	N 77 E	09	7.8	SUGAR	10	N 14 W	07
	ASH	10	S 25 E	26		SUGAR	12	S 58 W	35		BEECH	16	S 14 E	10
15.21	CHERRY	15	N 85 W	16	17.23	ASH	12	N 77 E	38	1.2	W. O.	36	WEST	3.00
	WAL	18	S 27 E	08		BEECH	20	S 33 W	33		-----	-----	-----	-----
21.22	W. OAK	12	S 38 E	04	17.18	SUGAR	12	N 27 E	20	1.7	SUGAR	12	SOUTH	8.50
	DO	14	N 66 W	37		LYNN	10	S 17 W	26		-----	-----	-----	-----

TOWNSHIP No. VII RANGE No. III CONTINUED

INTERIOR SECTION CORNERS BLACK-LINES

SECTION	BEARING	INCHES	COURSE	LINKS	SECTION	BEARING	INCHES	COURSE	LINKS
CORNERS	TREES	DIAM.	THEY BEAR	DISTANT	CORNERS	TREES	DIAM.	THEY BEAR	DISTANT
7. 8 13. 14	SUGARTREE	13	N 44 E	22	20. 21 26. 27	W. OAK	38	N 8 E	29½
8. 9 14. 15	DO	09	S 58 E	13	14. 15 20. 21	HICKORY	10	S 2 W	38
2. 3 8. 9	ELM	13	N 73½ W	16	21. 22 27. 28	W. OAK	10	N 55 E	18
	BEECH	15	S 27 E	29	22. 23 28. 29	DO	15	S 3 W	29
	HICKORY	21	CORNER TREE	4		DO	12	S 63 E	14
9. 10 15. 16	BEECH	14	N 3 W	25		ELM	06	N 14 W	14
	W. OAK	14	S 24 E	24		DOGWOOD	06	CORNER TREE	
10. 11 16. 17	DO	17	S 23 E	24		W. OAK	14	N 88 E	09½
4. 5 10. 11	B. OAK	17	N W	20½	23. 24 29. 30	B. OAK	30	N 36 W	09½
	DO	40	N 31 W	2½		W. OAK	13	S 15½ E	30½
	HICKORY	11	S 14 W	14		DO	11	N 18½ E	34
11. 12 17. 18	SUGARTREE	12	N 84 W	09	26. 27 32. 33	DO	10	N 52 E	23
	B. OAK	14	S 1½ E	40½		SPANISH O.	17	S 13½ E	13
	HICKORY	10	N 48 W	23	28. 29 34. 35	W. OAK	08	N 31½ W	09½
19. 20 25. 26	SUGARTREE	13	S 56 E	22		DO	14	S E	52
	W. OAK	15	N 65½ E	26	16. 17 22. 23	SUGARTREE	12	S 78 E	19
			S 61 W	54		BEECH	14	N 59 W	36

INTERIOR SECTION CORNERS RED-LINES

SECTION	BEARING	INCHES	COURSE	LINKS	SECTION	BEARING	INCHES	COURSE	LINKS
CORNERS	TREES	DIAM.	THEY BEAR	DISTANT	CORNERS	TREES	DIAM.	THEY BEAR	DISTANT
29. 30 35. 36	W. OAK	18	N 3 W	21	27. 28 33. 34	W. OAK	20	N 64 E	22
	DO	16	S 28 W	38	25. 26 31. 32	WAL.	12	S 48 W	43
17. 18 23. 24	W. OAK	16	N 76 W	30	15. 16 21. 22	W. OAK	16	S 29 E	06
	SUGAR	15	N 87 E	47		HICKORY	14	N 32 W	17
5. 6 11. 12	B. OAK	15	EAST	25		SUGAR	14	EAST	07
	BEECH	15	N 78 W	40		W. O.	16	S 59 W	21
3. 4 9. 10	W. OAK	15	EAST	09	13. 14 19. 20	W. O.	14	N 84 W	14
	DO	24	WEST	57		DO	18	N 82 E	16
7. 8	SUGAR	08	N 45 W	07					
	W. OAK	40	S 45 E	10					

(A TRUE COPY)
DAVID HOCE REC.

A TRUE COPY
BY
JOHN A BOND
© 1894