



# TOWNSHIP No. V RANGE No. III.

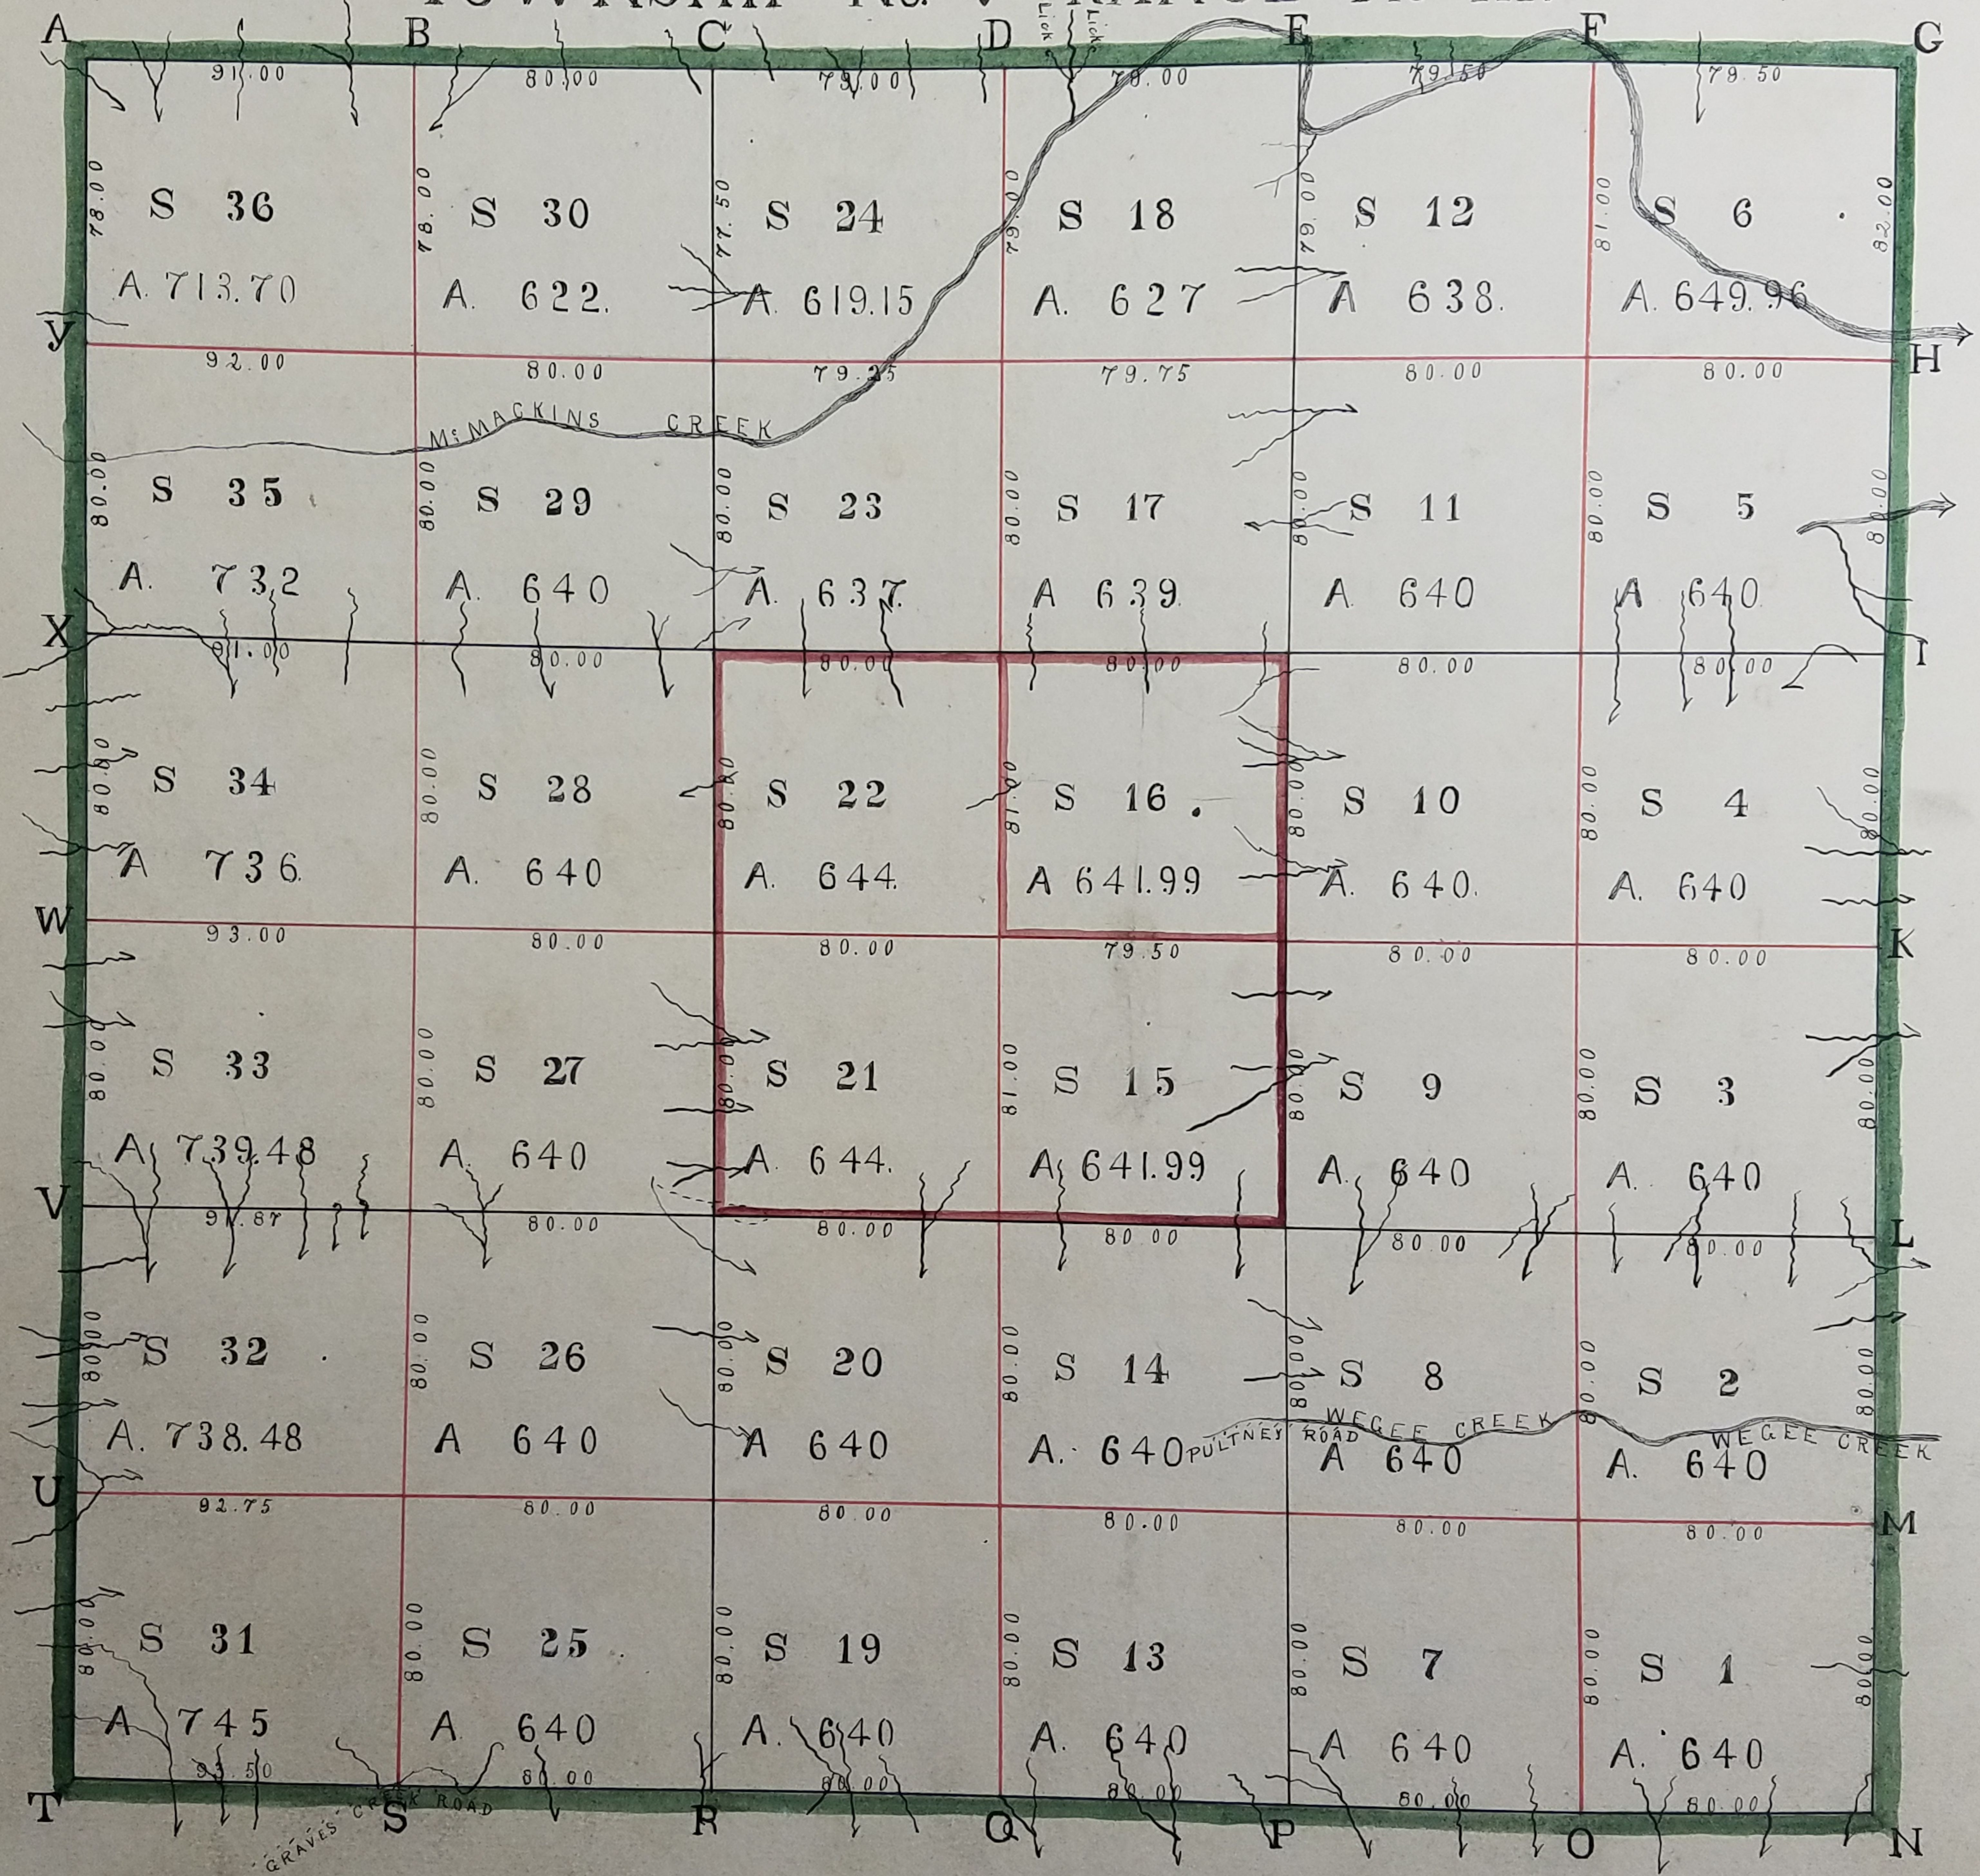

(A TRUE COPY)  
DAVID, HOCE, REG.

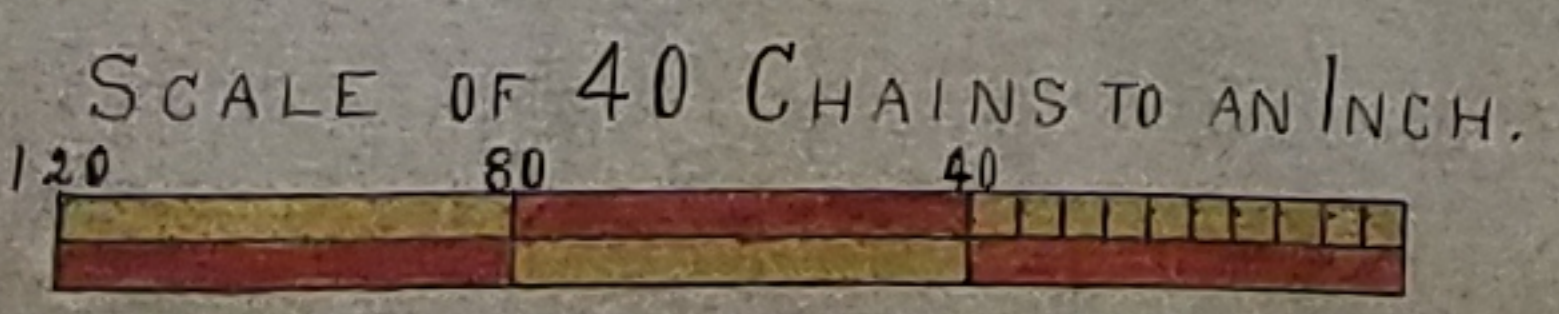

A TRUE COPY  
BY  
JOHN A. BOND  
1894.



## TOWNSHIP V RANGE III CONTINUED.

## INTERIOR SECTION CORNERS BLACK-LINES.

SECTION CORNERS	BEARING TREES	INCHES DIAM.	COURSE THEY BEAR	LINKS DISTANT	SECTION CORNERS	BEARING TREES	INCHES DIAM.	COURSE THEY BEAR	LINKS DISTANT	
7 13	8 14	W. OAK	12	N 71 W	18	20 26	21 27	W. OAK	42	CORNER TREE
		B. OAK	16	S 42 E	30			HICKORY	09	N 3 E
8 14	9 15	W. OAK	16	S 15 E	09			BEECH	12	S 13 E
		BEECH	10	N 42 1/2 W	11	14 20	15 21	B. OAK	12	S 12 W
2 8	3 9	B. OAK	36	EAST	34			GUM	12	N 21 1/2 E
		BEECH	06	S 67 1/2 W	07	21 27	22 28	W. OAK	10	N 9 E
9 15	10 16	ASH	08	N 36 1/2 W	06			DO	09	S 9 W
		HICKORY	10	S 39 1/2 E	52	22 28	23 29	GUM	12	N 35 E
10 16	11 17	CHEST. OAK	13	S 71 W	15			POPLAR	13	S 4 E
		CHESTNUT	10	N 61 E	24	16 22	17 23	W. OAK	13	N 20 E
4 10	5 11	SUGARTREE	18	N 73 E	14 1/2			DO	10	SOUTH
		DO	12	S 58 W	19	23 29	24 30	ELM	24	N 65 E
11 17	12 18	IRONWOOD	05	N 78 E	02			HICKORY	17	S 65 W
		W. OAK		S 15 W	18	26 32	27 33	B. OAK	20	THIS TREE IS IN THE
19 25	20 26	DO	13	S 81 E	19 1/2			PLACE OF POST * NO BEARINGS TAKEN		
		DO	18	S 65 1/2 W	29	28 34	29 35	SUGARTREE	09	NO BEARING TREES
								TAKEN AT THIS POINT		

RED LINES  
TOWNSHIP V RANGE III CONTINUED.  
QUARTER SECTION POSTS DESCRIBED.

QUARTER POSTS	BEARING TREES	INCHES DIAM.	COURSE THEY BEAR	LINKS DISTANT	QUARTER POSTS	BEARING TREES	INCHES DIAM.	COURSE THEY BEAR	LINKS DISTANT	QUARTER POSTS	BEARING TREES	INCHES DIAM.	COURSE THEY BEAR	LINKS DISTANT
BETWEEN SECTIONS 30-36	W. OAK	18	S 17 E	17	14-20	ELM	06	CORNER TREE		BETWEEN SECTIONS 18-24	SUGAR	09	N 32 E	10
	DO	14	N 57 W	48		IRON.	08	S 31 W	11		HICKORY	12	S 21 W	11
29-35	DO	09	WEST	06		REDOAK	16	S 80 E	36	17-23	SUGAR	08	S 49 W	07
	HICKORY	09	S 71 E	66	13-14	SUGAR	15	N 65 E	18		W. OAK	16	N 68 E	25
27-33	W. OAK	10	S 27 W	22		LINN	18	WEST	17	23-24	SUGAR	12	N 47 E	15
	DO	12	N 14 E	23	19-20	HICKORY	16	S 71 E	06		DO	12	S 43 W	18
27-28	POP.	09	N 1 E	13		BEECH	15	N 52 W	24	3-4	W. OAK	24	S 52 W	13
	W. OAK	14	S 9 W	35	13-19	SUGAR	16	SOUTH	08		WAL.	14	N 57 E	25
33-34	DO	07	N 64 W	09		DO	16	N 4 W	39	4-10	SUGAR	12	S 6 E	20
	DO	07	S 45 E	20	1-7	SUGAR	06	S 42 W	18		ASH	10	N 41 W	55
28-34	DO	16	N 10 W	13		DO	10	N 2 W	30	3-9	SUGAR	12	S 35 E	21
	DO	18	SOUTH	24	1-2	ASH	18	S 43 E	19		DO	14	N 54 W	47
29-30	DO	30	S 66 W	03		SUGAR	18	S 62 E	33	9-10	BEECH	14	N 7 E	09
	SUGAR	14	N 66 E	56	7-8	W. OAK	16	N 4 W	09		SUGAR	18	S 11 W	28
35-36	ASH	12	N 74 W	11		HICKORY	07	S 10 E	11	15-16	DOGWOOD	06	N 10 E	10
	ELM	12	S 82 E	55	2-8	SUGAR	05	N 75 W	17		W. OAK	12	S 53 W	10
31-32	CHERRY	09	N 26 W	04		WAL.	06	S 85 E	34	16-22	CHEST.	15	WEST	29
	W. OAK	16	S 26 E	23	6-12	DO	30	N 32 E	21		B. OAK	04	N 76 E	15
26-32	SUGAR	16	N 56 E	14		BEECH	12	S 68 W	15	15-21	R. OAK	15	S 88 W	15
	HICKORY	16	S 72 W	29	5-11	SUGAR	05	S 91 W	22		SUGAR	08	S 44 E	30
25-31	W. OAK	15	S 26 W	11		CHEST.	12	N 45 E	30	21-22	ELM	06	S 88 W	44
	GUM	16	N 28 E	21	11-12	BEECH	05	S 57 E	22		SUGAR	07	N 84 E	48
25-26	BEECH	07	N 41 E	38		SUGAR	12	N 55 W	56	5-6	DO	06	S 86 W	09
	DO	24	S 8 W	47	17-18	HICKORY	20	S 48 W	05		DO	12	N 74 E	12
						W. OAK	14	N 11 E	09					

INTERIOR SECTION CORNERS RED-LINES.

SECTION CORNERS	BEARING TREES	INCHES DIAM.	COURSE THEY BEAR	LINKS DISTANT	SECTION CORNERS	BEARING TREES	INCHES DIAM.	COURSE THEY BEAR	LINKS DISTANT
29-30 35-36	BEECH	08	SOUTH	04	5-6 11-12	SUGAR	16	S 20 E	40
	W. OAK	14	N 4 W	59		DO	12	N 50 E	28
27-28 33-34	DO	17	S 83 E	19	17-18 23-24	ASH	12	S 6 E	57
	HICKORY	12	S 62 W	54		CHERRY	14	N 3 W	66
25-26 31-32	GUM	10	S 30 W	07	3-4 9-10	SUGAR	12	N 9 W	09
	W. OAK	20	N 64 E	38		HICK.	15	S 4 W	51
13-14 19-20	HICK.	06	S 38 W	10	15-16 21-22	W. O.	10	S 74 E	09
	W. OAK	20	N 22 E	43		DO	16	N 86 W	17
1-2 7-8	POPLAR	12	N 86 E	34					
	W. OAK		N 85 W	28					

A TRUE COPY  
BY DAVID HOCE REQ.

A TRUE COPY  
BY  
JOHN A. BOND  
1894